


# 吉良上横須賀北土地区画整理事業 画地出来形確認測量図

縮尺 1000分の1

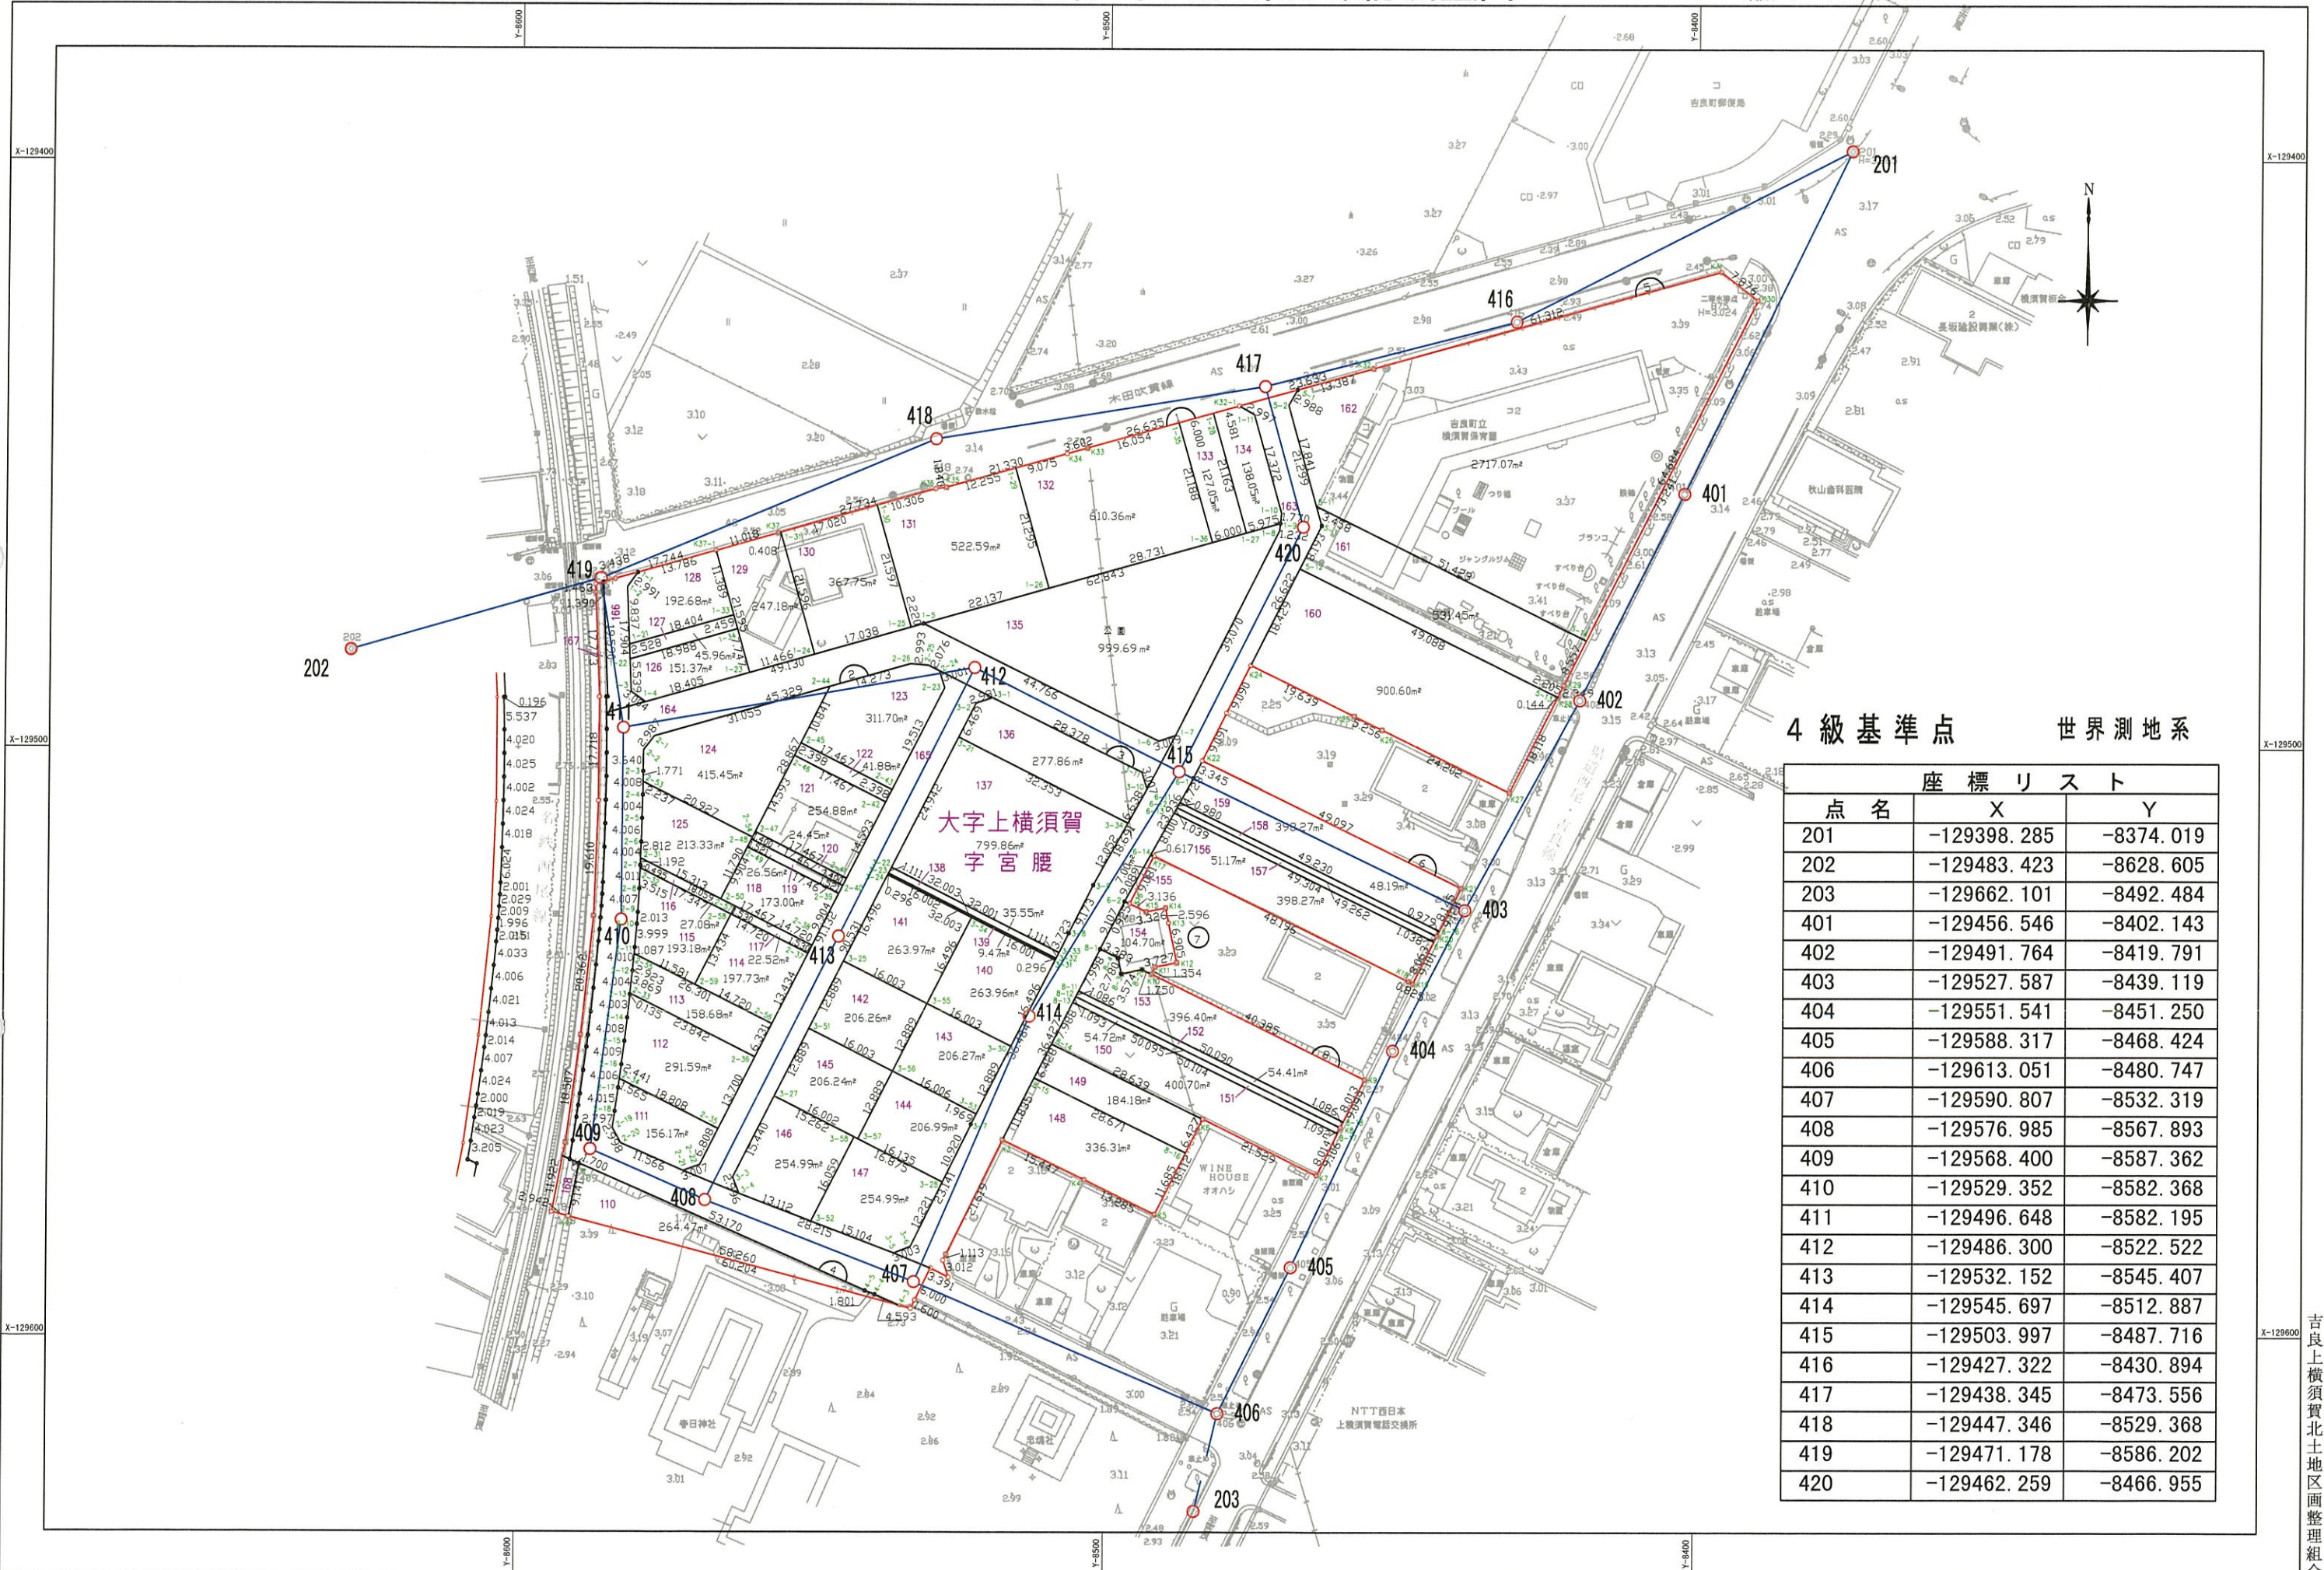

4級基準点 世界測地系

座標リスト		
点名	X	Y
201	-129398.285	-8374.019
202	-129483.423	-8628.605
203	-129662.101	-8492.484
401	-129456.546	-8402.143
402	-129491.764	-8419.791
403	-129527.587	-8439.119
404	-129551.541	-8451.250
405	-129588.317	-8468.424
406	-129613.051	-8480.747
407	-129590.807	-8532.319
408	-129576.985	-8567.893
409	-129568.400	-8587.362
410	-129529.352	-8582.368
411	-129496.648	-8582.195
412	-129486.300	-8522.522
413	-129532.152	-8545.407
414	-129545.697	-8512.887
415	-129503.997	-8487.716
416	-129427.322	-8430.894
417	-129438.345	-8473.556
418	-129447.346	-8529.368
419	-129471.178	-8586.202
420	-129462.259	-8466.955