


西尾上矢田西山土地区画整理事業 画地出来形確認測量図

縮尺 1:1000

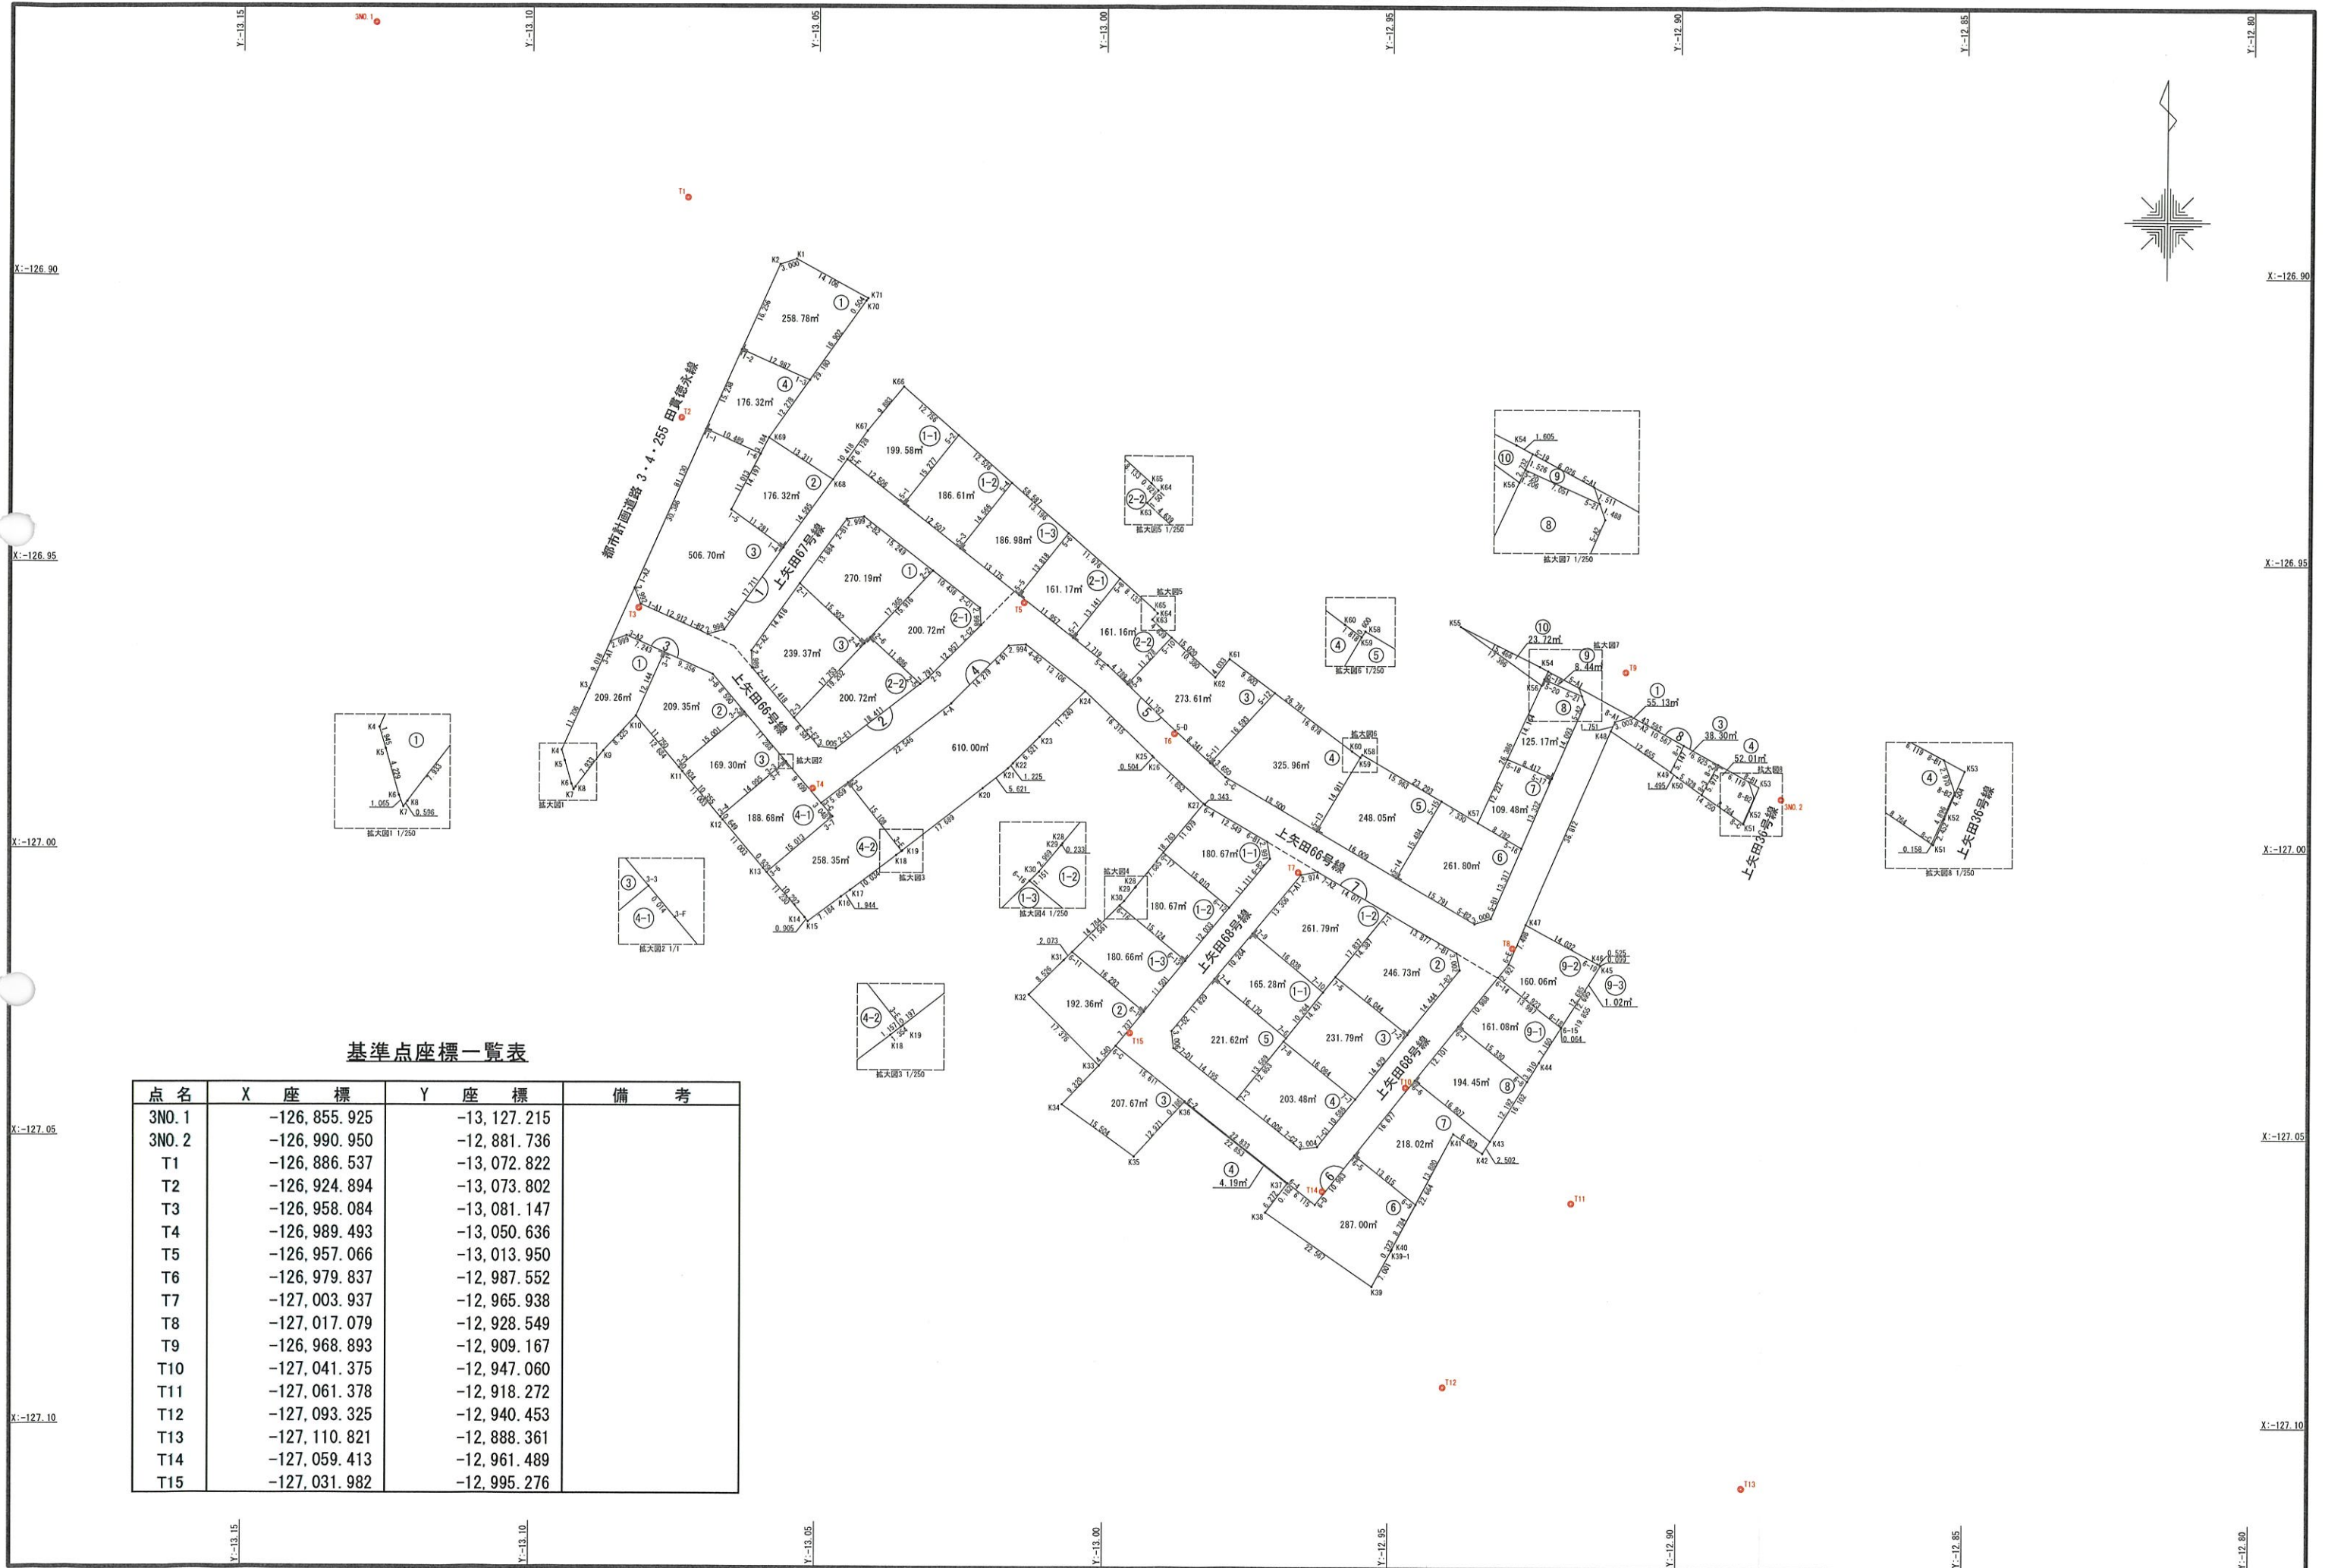

基準点座標一覧表

点名	X 座標	Y 座標	備考
3NO. 1	-126,855.925	-13,127.215	
3NO. 2	-126,990.950	-12,881.736	
T1	-126,886.537	-13,072.822	
T2	-126,924.894	-13,073.802	
T3	-126,958.084	-13,081.147	
T4	-126,989.493	-13,050.636	
T5	-126,957.066	-13,013.950	
T6	-126,979.837	-12,987.552	
T7	-127,003.937	-12,965.938	
T8	-127,017.079	-12,928.549	
T9	-126,968.893	-12,909.167	
T10	-127,041.375	-12,947.060	
T11	-127,061.378	-12,918.272	
T12	-127,093.325	-12,940.453	
T13	-127,110.821	-12,888.361	
T14	-127,059.413	-12,961.489	
T15	-127,031.982	-12,995.276	